


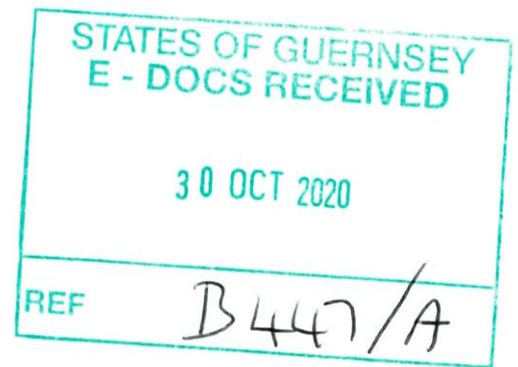

States of Guernsey
Planning Service

Your Ref:

Planning Service
Sir Charles Frossard House
La Charroterie
St. Peter Port
Guernsey
GY1 1FH



25 August 2020

Application Ref No: FULL/2020/1569

THE LAND PLANNING AND DEVELOPMENT (GUERNSEY) LAW, 2005

Invalid Application Checklist

- PROPOSAL:** Variations to previously approved plans to erect 1.5 storey extension to north-west (side) elevation, install dormer window and rooflight and alterations to fenestration - Demolish chimney and erect flue.
- LOCATION:** Rasa Sayang Rue De La Mare St. Sampson
- APPLICANT:** Mr A Rimington
- AGENT:** Mr A Rimington

Please ensure you have provided all the information requested in the attached letter, and again listed below, in order that your application may be registered as valid. Please return the checklist with 4 paper copies of the information, (professional agents/people acting on behalf of 3rd parties/organisations to submit one of these copies electronically, please include in the email subject line the following text and Information: "Invalid Planning Application + Agent Ref + Planning Application Reference").

Checklist:

Please find enclosed block plans at a scale of 1:200, please check that the red boundary line is correct. ✓

Please mark out and label the area for the previously approved extension and clearly mark the position of the chimney to be removed and the proposed flue and highlight/bubble in red the area of development to be considered as variation to previously approved. ✓

Please revise the elevation drawings, highlight or bubble in red the area of the development to be considered as a variation.

Please return this sheet with the above requested information to the Planning Service.

INFO FILED IN ON DRAWINGS

AM

Application Block Layout Plan

STATES OF GUERNSEY
E-DOCS RECEIVED

30 OCT 2020


REF

CORRECT
BOUNDARY.

REMOVE RECTANGLE
STACK AND REPLACE
WITH ROUND CURB

EXT

RUE DE LA MARE

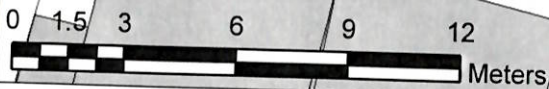

Copyright States of Guernsey 2020



Rasa Sayang
Rue De La Mare
Roland Road
St. Sampson
GUERNSEY
GY2 4PG

Applicants Name : A. RINGGOW
NB Please indicate any amendments required to the address shown :-

Scale 1:200

NB The details on this plan are illustrative, not defined. The coloured boundary illustrated above does not necessarily indicate the extent of the property or curtilage